


JGM PROPERTIES

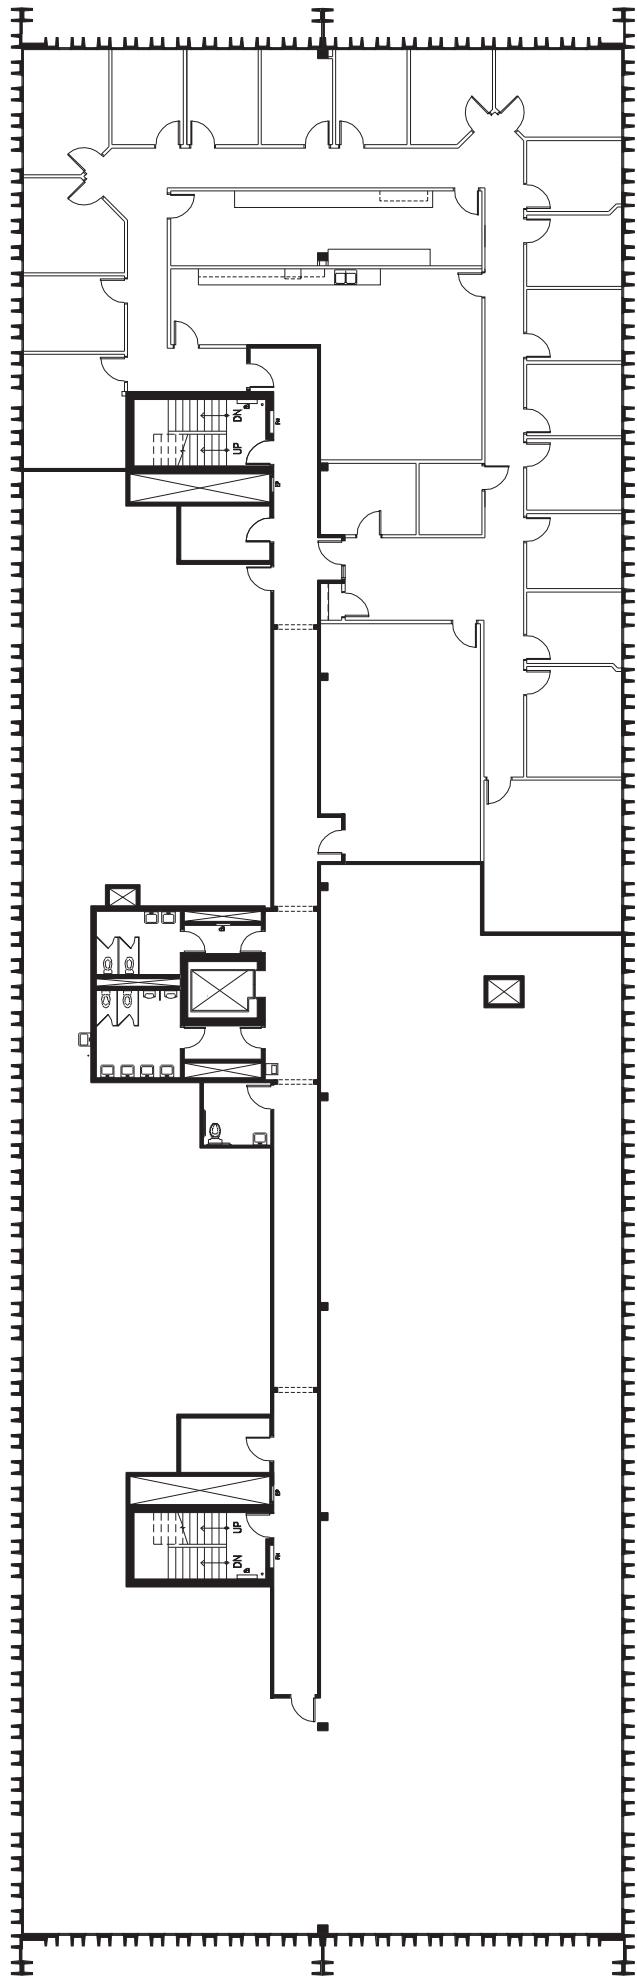

CENTURY OFFICE PARK - THIRD FLOOR
6063 HUDSON ROAD
WOODBURY, MN 55125

AS-BUILT PLAN

 **Archimea**
Interior Design Services, Inc.
3021 Metro Drive • Suite #10 • Brooklyn Park, MN 55428 • 952.455.5036

DATE: 04/25/13
